
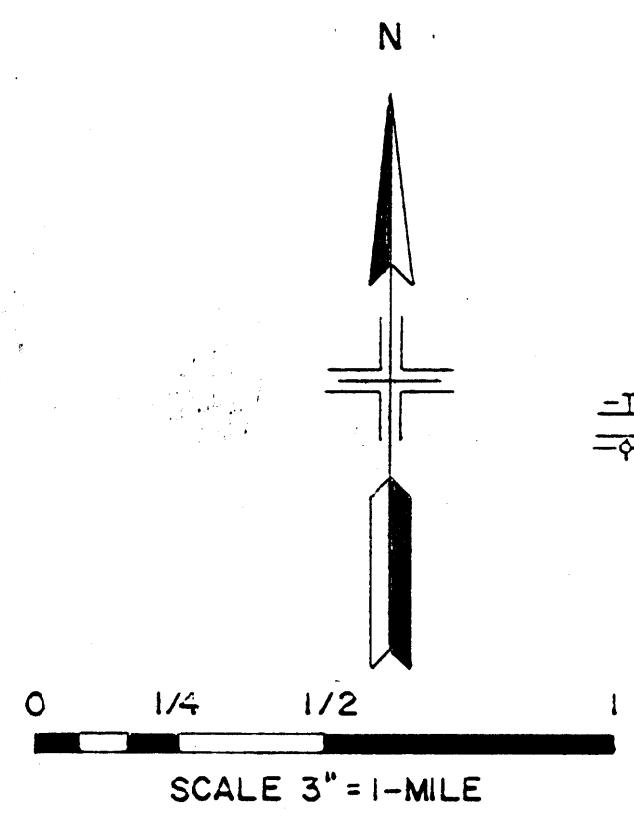


Rev.
4-16-86

PLANS DITCH NO. 1 YELLOW MEDICINE RIVER WATERSHED DISTRICT MINNESOTA

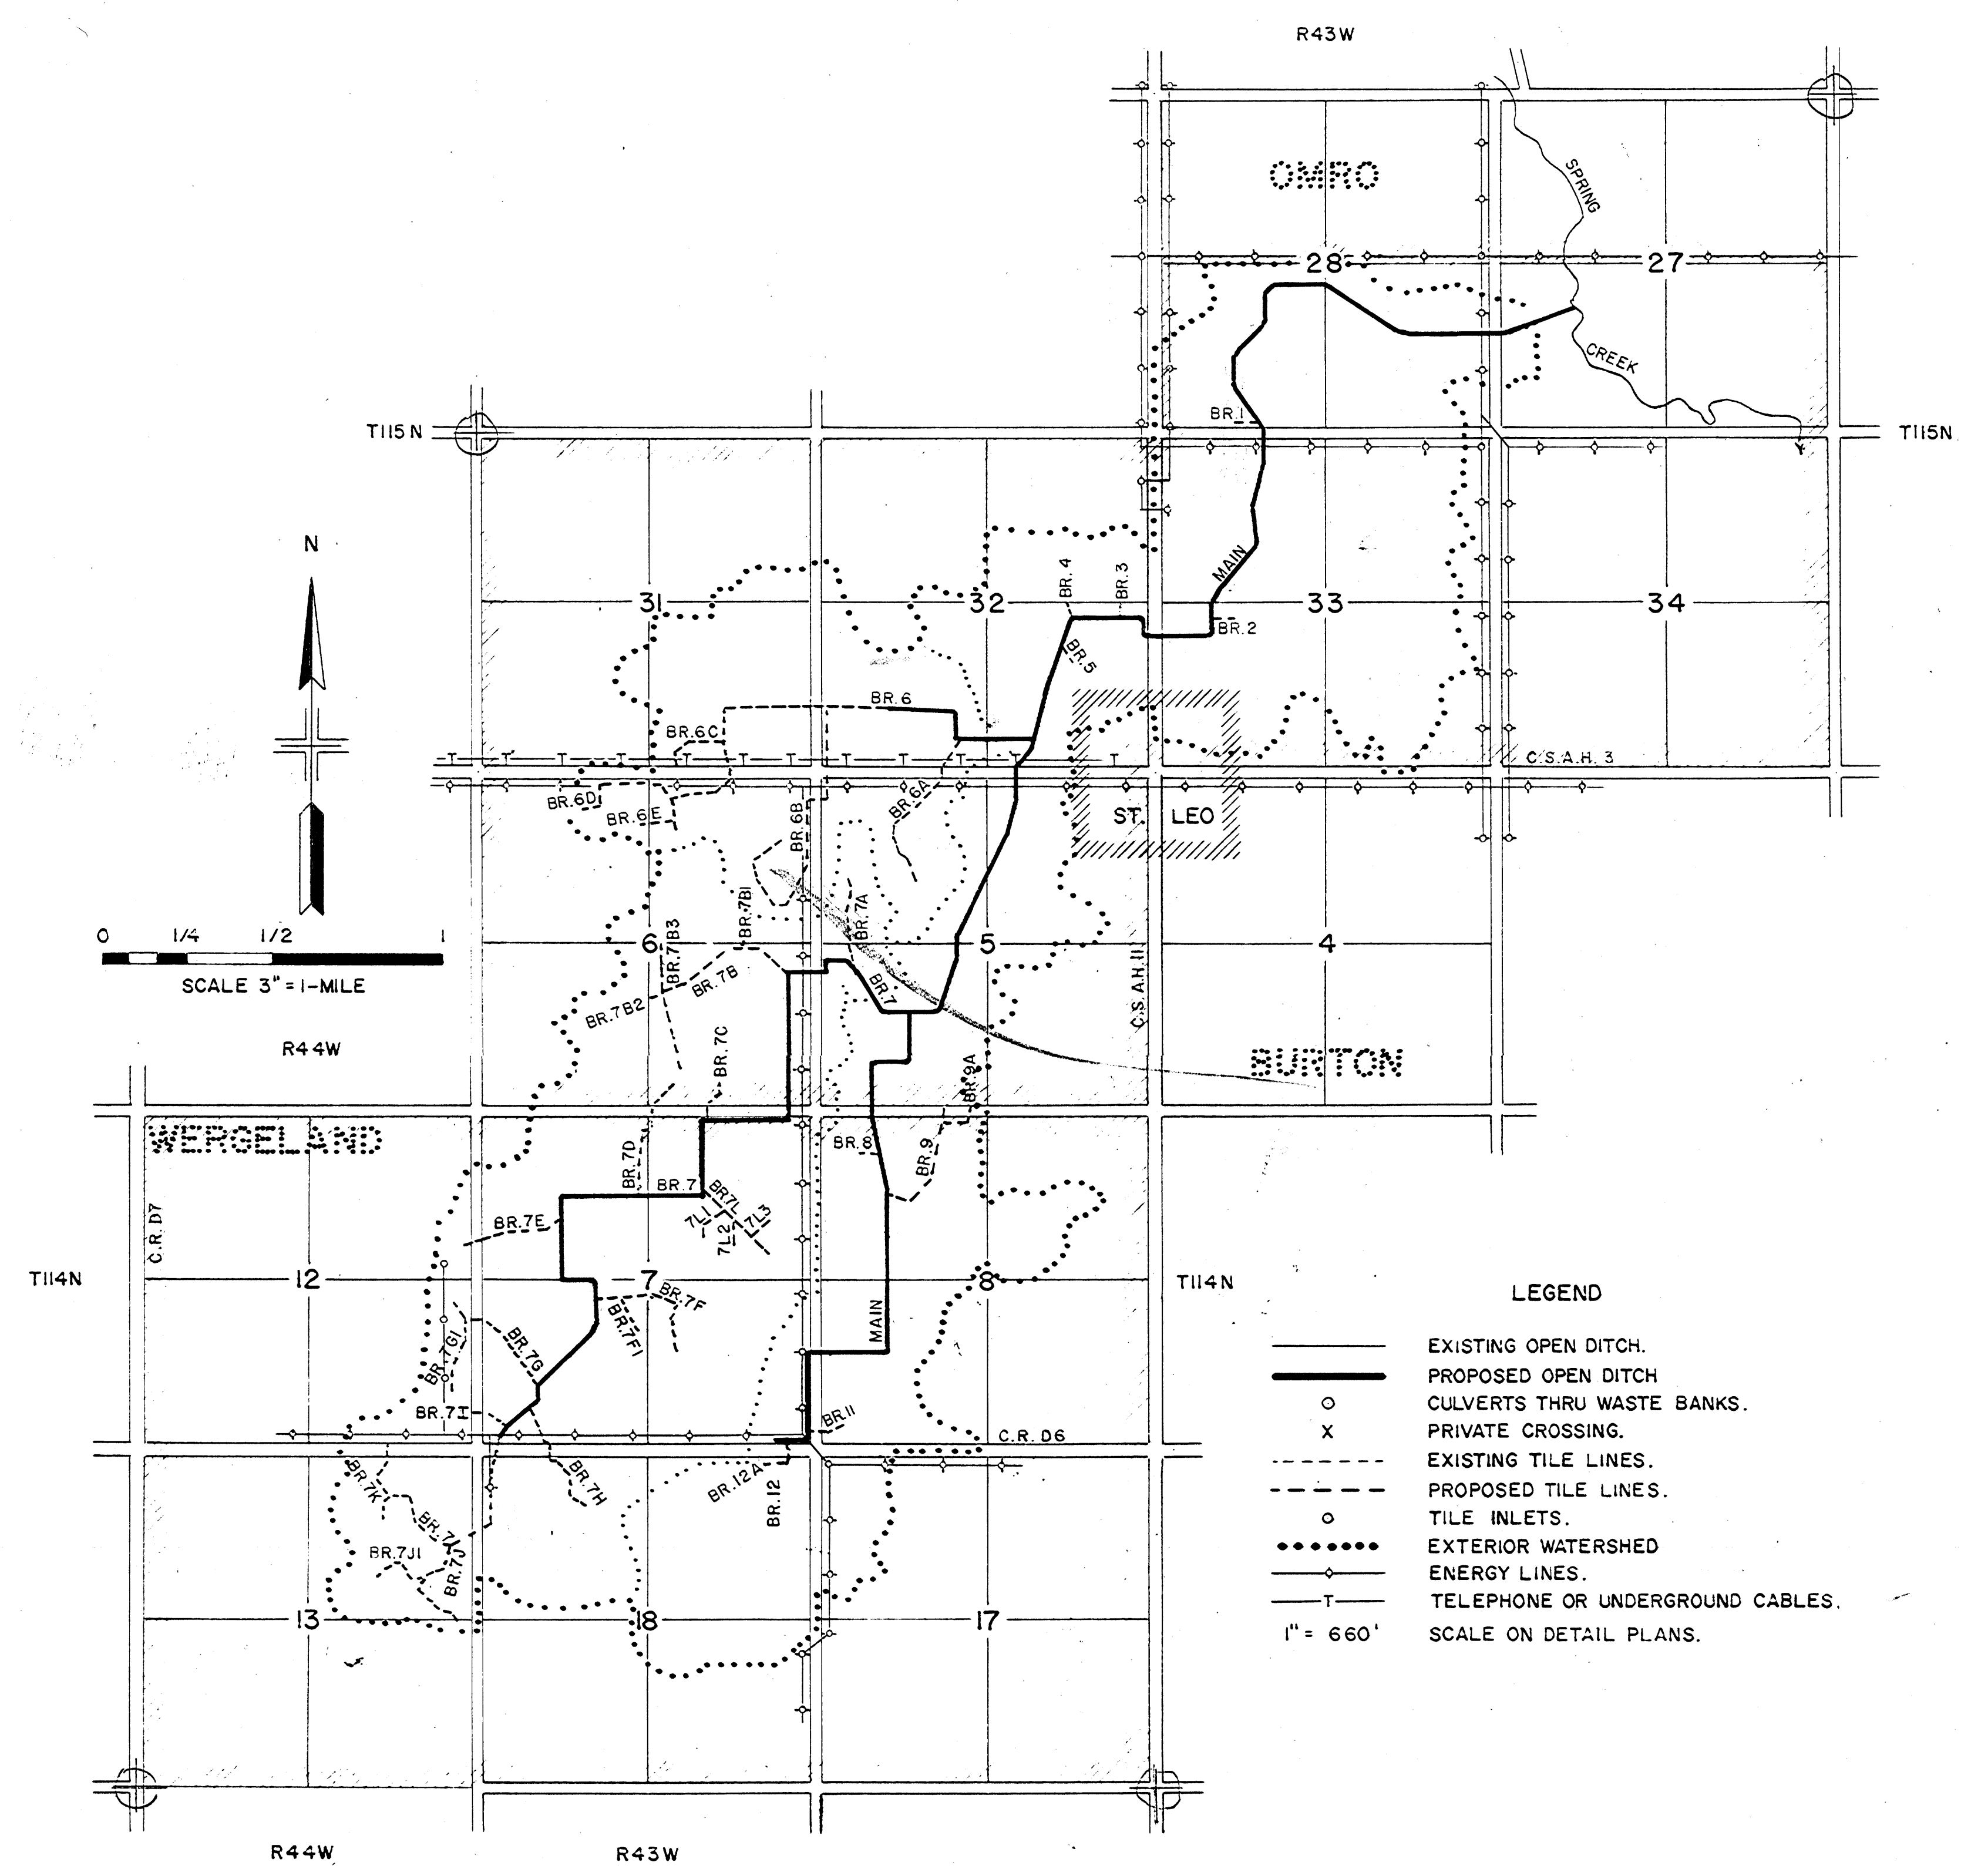

- LEGEND**
- EXISTING OPEN DITCH.
 - - - PROPOSED OPEN DITCH
 - CULVERTS THRU WASTE BANKS.
 - X PRIVATE CROSSING.
 - - - EXISTING TILE LINES.
 - - - PROPOSED TILE LINES.
 - TILE INLETS.
 - EXTERIOR WATERSHED
 - ENERGY LINES.
 - - - TELEPHONE OR UNDERGROUND CABLES.
- 1" = 660'
SCALE ON DETAIL PLANS.

INDEX

| | |
|--------------|--|
| SHEET NO. 1 | KEY MAP & INDEX. |
| SHEET NO. 1A | ESTIMATED QUANTITIES. |
| SHEET NO. 2 | PLAT OF SECTIONS 27, 28, 31, 32 & 33 IN OMRO TWP. T115N, R43W. & SECTIONS 5 & 6 IN BURTON TWP. T114N, R43W. |
| SHEET NO. 3 | PLAT OF SECTIONS 7, 8, 17 & 18 IN BURTON TWP. T114N, R43W. & SECTIONS 12 & 13 IN WERGELAND TWP. T114N, R44W. |
| SHEET NO. 4 | PROFILE OF MAIN. |
| SHEET NO. 5 | PROFILE OF MAIN & BRANCHES 1, 2, 3, 4, 5, 6, 6A, 6B, 6C, 6D, & 6E. |
| SHEET NO. 6 | PROFILE OF BRANCHES 7, 7A, & 7B. |
| SHEET NO. 7 | PROFILE OF BRANCHES 7B1, 7B2, 7B3, 7C, 7D, 7E, 7F, 7F1, 7G, 7G1, 7H, & 7I. |
| SHEET NO. 8 | PROFILE OF BRANCHES 7J, 7J1, 7K, 7L, 7L1, 7L2, 7L3, 8, 9, 9A, 11, 12, & 12A. |
| SHEET NO. 9 | DETAILS OF OPEN DITCH OUTLET PIPE & TILE INLETS. |

| | | | |
|---|--------------|----------------|--------------|
| TED L. CHAMBERLAIN, ENGINEER, MONTEVIDEO, MINNESOTA | | | |
| MAPPING | C. G. 4-73 | DESIGN | |
| PRELIM. SURVEY | L. T. 112-73 | DRAFTING | L. C. 112-75 |
| DESIGN | G. S. 2-74 | REVISED | |
| DRAFTING | W. H. 2-74 | CONST. SURVEY | L. T. 76-77 |
| FINAL SURVEY | | CORRECTED PLAN | V. S. 2-86 |
| PLANS CORRECTED TO SHOW DITCH AS CONSTRUCTED | | | |